


<div>1. VERIFY ALL HVAC & KITCHEN EQUIPMENT PRIOR TO ROUGH IN.</div> <div>2. ALL TELEPHONE/DATA/TV CABLES AND WIRES TERMINATIONS; ALL REQUIRED CABLE; AND JACKS WILL BE INSTALLED BY THIRD PARTY.</div> <div>3. POWER SUPPLY FOR COMPUTER, CASH REGISTER (83A, & 86A, OR 87, & 94) SHALL BE ON THE SAME CIRCUIT BREAKER, W/ ISOLATED GROUND & ORANGE RECEPTACLE.</div> <div>4. ALL CIRCUITRY SHOWN WITHOUT TICKS SHALL HAVE (2) WIRES PLUS EQUIPMENT GROUNDING CONDUCTOR.</div> <div>5. WHEN WORKING IN JURISDICTIONS WHICH HAVE ADOPTED THE 2008 NEC OR LATER, ALL MULTI-WIRE BRANCH CIRCUITS SHALL HAVE SEPARATE NEUTRALS TO MEET THE REQUIREMENTS OF 2008 NEC 210.4(B).</div>		<div>1. ALL CIRCUITRY/CONDUIT FOR FRONT LINE EQUIPMENT TO BE ROUTED IN CASEWORK TO J-BOX IN WALL AND CONCEALED IN WALL.</div> <div>2. PROVIDE (2) 1" CONDUITS WITH PULL STRINGS FROM CASH REGISTER TO MANAGER STATION. SEE P.O.S. AND SERVICE LINE ELEVATIONS, SHEET 3/E-200.</div> <div>3. SEE 'MANAGER STATION ELEVATION' 1 / E-200 FOR ADDITIONAL OUTLETS AND J-BOXES.</div> <div>4. ANSUL PULL STATION. REFER TO DETAIL, SHEET 2 / E-400.</div> <div>5. HOOD CONTROL PANEL/ANSUL SYSTEM CABINET, MOUNT CABINET DIRECTLY BELOW T-BAR CEILING.</div> <div>6. PROVIDE 2-GANG J-BOX @ 48" AFF FOR HOOD CONTROL SWITCHES. REFER TO M-400, M-401 AND M-402.</div> <div>7. PROVIDE WP, IN-USE RED DOT (#CKSUV).</div> <div>8. ALL DEVICES UNDER HOOD TO BE PROVIDED AND INSTALLED WITH SHUNT TRIP CIRCUIT BREAKER AND WATERPROOFING BOX (RED DOT #CKSUV). REFER TO COOKLINE ELECTRICAL ELEVATIONS, SHEET 6/E-200.</div> <div>9. ELECTRIC GRILL '23B': FEED WITH 3 #8, #10 GROUND, 3/4" CONDUIT. PROVIDE A REMOTE GFI TRIP DEVICE IN ACCORDANCE W/ NEC 210.8 (B)(2). INSTALL IN AN ACCESSIBLE LOCATION IN THIS GENERAL AREA, OR AS DIRECTED BY THE OWNER, ARCHITECT OR ENGINEER. SEE DETAIL 2/E-200 FOR ADDITIONAL INFORMATION.</div> <div>10. FURNISH AND INSTALL A HUBBELL GFSTBF20 FACELESS GFCI (OR EQUIVALENT) FOR CIRCUIT FEEDING EQUIPMENT BENEATH THE KITCHEN HOOD WHICH UTILIZE SINGLE 20A, 120V RECEPTACLES. INSTALL IN AN ACCESSIBLE LOCATION IN THIS GENERAL AREA, OR AS DIRECTED BY THE OWNER, ARCHITECT OR ENGINEER. PROVIDE ADDITIONAL OUTLETS AS REQUIRED TO FEED ALL SUCH LOADS BENEATH HOOD. FASTEN A PLASTIC LABEL STATING CIRCUIT AND EQUIPMENT SERVED FOR EACH OUTLET.</div> <div>11. SEE 3/E-200 FOR SERVICE LINE ELEVATIONS.</div> <div>12. CONNECT HEAT LAMPS TO COUNTER-MOUNTED SWITCH PROVIDED AND INSTALLED BY CONTRACTOR. REFER TO PLAN FOR LOCATIONS AND QUANTITIES.</div>				
POWER PLAN GENERAL NOTES		2	#	POWER PLAN KEYED NOTES		3
	NOT TO SCALE	E-100			NOT TO SCALE	E-100



ALL SINGLE-PHASE RECEPTACLES RATED 150 VOLTS TO GROUND OR LESS; 50 AMPERES OR LESS AND THREE PHASE RECEPTACLES RATED 150 VOLTS TO GROUND OR LESS; 100 AMPERES OR LESS INSTALLED IN KITCHEN AREAS SHALL BE GROUND FAULT PROTECTED AS REQUIRED BY NEC 210.8 (B) (2).

NO UNDER SLAB ELECTRICAL WORK ALLOWED
UNLESS OTHERWISE NOTED ON PLAN.

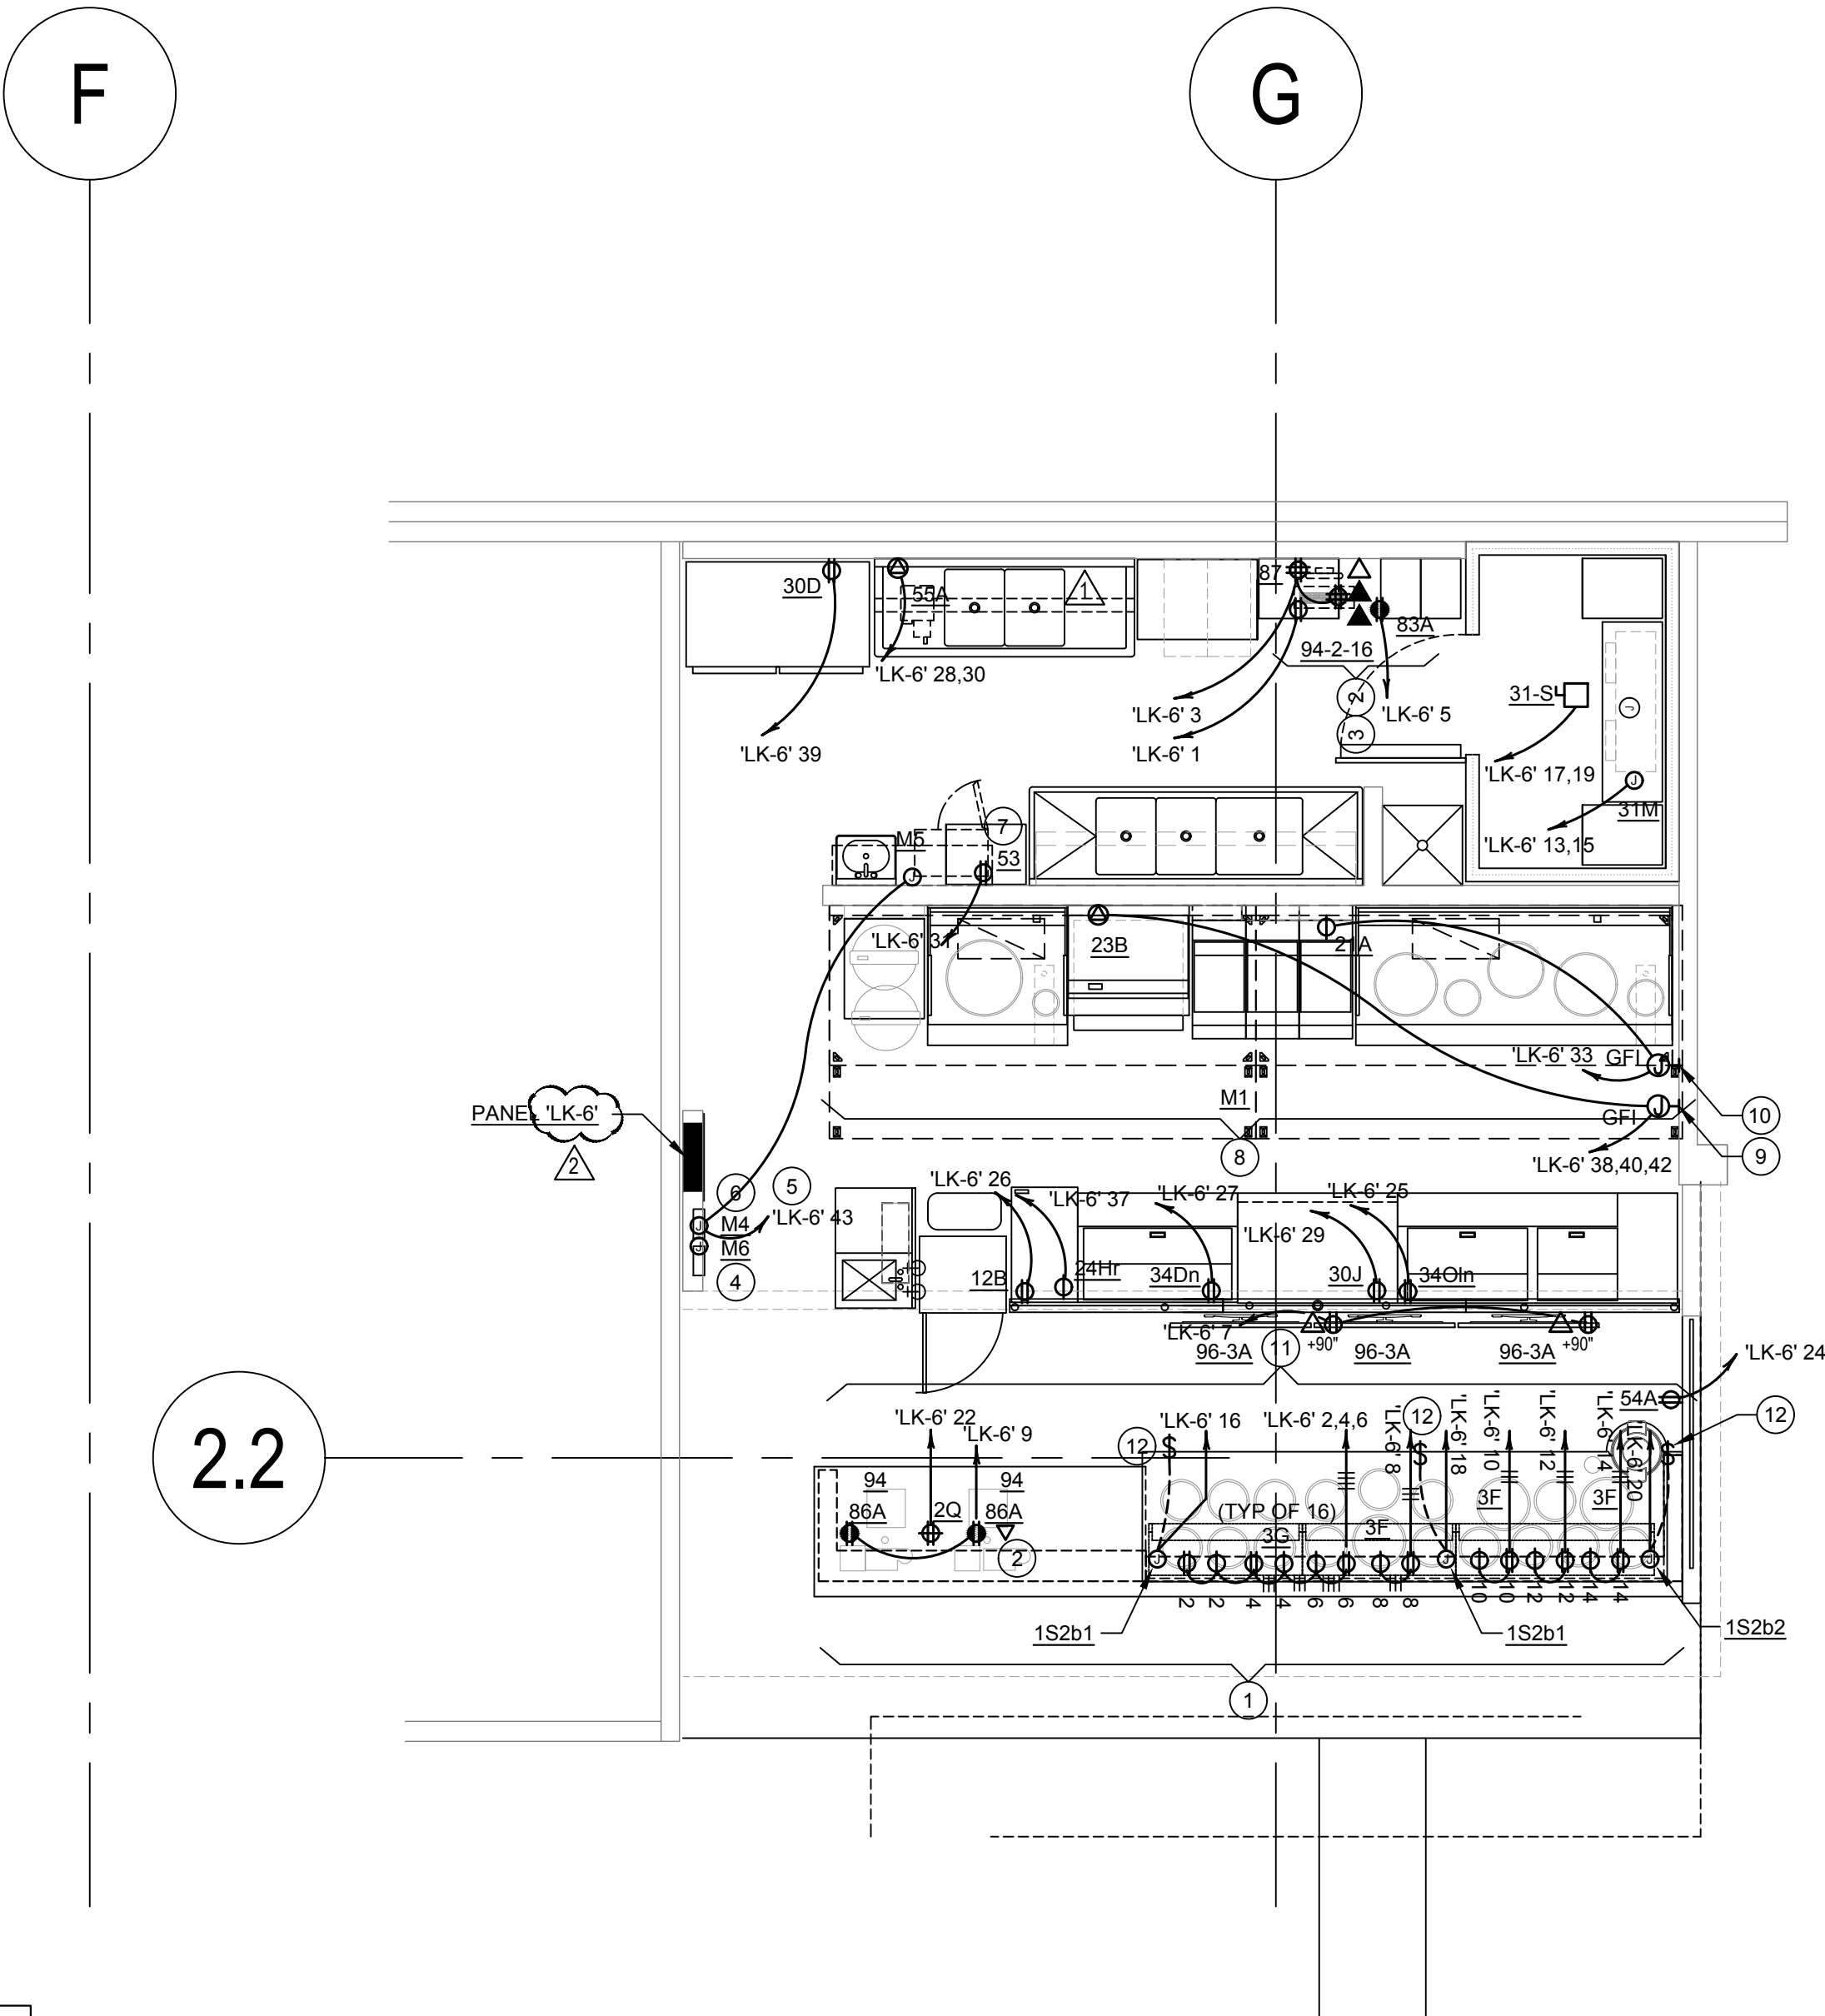

PANDA RESTAURANT GROUP INC.
1683 Walnut Grove Ave.
Rosemead, California
91770
Telephone: 626.799.9898
Facsimile: 626.372.8288

All ideas, designs, arrangement and plans indicated or represented by this drawing are the property of Panda Express Inc. and were created for use on this specific project. None of these ideas, designs, arrangements or plans may be used by or disclosed to any person, firm, or corporation without the written permission of Panda Express Inc.

REVISIONS:

PLAN REVIEW COMMENTS	03/26/2021
REVISED LABLE	05/11/2021

ISSUE DATE:

1	95% SUBMITTAL	01/11/2020
2	100% SUBMITTAL	04/16/2021
3	100% RESUBMITTAL	05/14/2021
4	FINAL SUBMITTAL	06/08/2021

DRAWN BY: JMJ

PANDA PROJECT #: D7395
ARCH PROJECT #:



MARSHALL & BOLLWERK
ENGINEERING, INC.
8881 Highway 92, Suite 400
Woodstock, Ga. 30189
p: (878) 795-0333, f: (878) 325-4559
e: mbe@mbeinc.net



PANDA EXPRESS

ROBINS AFB SHOPPING CENTER
ROBINS AFB, GA

E-100

POWER FLOOR PLAN

BID SET - 2021/06/28