CORNER RECORD

Agency Index BK 99 PG 20
Document Number CR 10283

City of EDEN TOWNSHIP County of ALAMEDA, California

Brief Legal Description BRASS DISK MONUMENT LOCATED WITHIN THE INTERSECTION OF CRESTFIELD DR AND CRESTFIELD CT.

CORNER TYPE

Government Corner	☐	Control	☒
Meander	☐	Property	☐
Rancho	☐	Other	☐

Date of Survey 6/6/17

COORDINATES (Optional)

N. 2074574± E. 6117851±

Elevation

Units Metric ☐ U.S. Survey Foot ☐

Horizontal Datum

Zone Epoch Date

Vertical Datum

☐ Complies with Public Resources Code §§8801-8819

☐ Complies with Public Resources Code §§8890-8902

PLS Act Ref:	☐ 8765(d)	☒ 8771	☐ 8773	☐ Other:
Corner/ Monument:	☒ Left as found	☐ Established	☐ Rebuilt	☐ Pre-Construction
	☐ Found and tagged	☐ Reestablished	☐ Referenced	☒ Post-Construction

Narrative of corner identified and monument as found, set, reset, replaced, or removed:

☐ See sheet #2 for description(s) : SEE CR 9479

FOUND BRASS DISK WITH PUNCH IN MONUMENT WELL.

FOUND AND SET POINTS AS SHOWN ON PAGE 2.
THIS POINT WAS FOUND IN GOOD CONDITION AFTER A CONSTRUCTION PROJECT IN THE VICINITY.
THE TIES SHOWN HEREON ARE FOR THE PURPOSE OF PERPETUATING FOUND MONUMENTATION.
NO CLAIM IS MADE AS TO THE RELATIONSHIP OF THE POINTS OR LINES SHOWN HEREON TO TRUE BOUNDARY LOCATION.

SURVEYOR'S STATEMENT

This Corner Record was prepared by me or under my direction in conformance with the Professional Land Surveyors' Act on JUNE 16, 2017.

Signed Scott V Cunha P.L.S. or ~~R.C.E.~~ No. LS 8525

SCOTT V. CUNHA

LICENSED LAND SURVEYOR
SCOTT V. CUNHA
NO. 8525
STATE OF CALIFORNIA

COUNTY SURVEYOR'S STATEMENT

This Corner Record was received 20 JULY, 2017

and examined and filed 18 AUGUST, 2017.

Signed Michael Rubner P.L.S. or ~~R.C.E.~~ No. 6843

Title COUNTY SURVEYOR

County Surveyor's Comment

LICENSED LAND SURVEYOR
MICHAEL RUBNER
No. 6843
STATE OF CALIFORNIA

SPEC-2315-PRE

Document Number CR 10283 Agency Index BK 99 PG 20

SCALE: 1"=30'

LEGEND

- FOUND BRASS DISK WITH PUNCH IN MONUMENT WELL
- FOUND CUT CROSS IN WALK
- FOUND CUT CROSS IN CURB
- FOUND MAG AND SHINER
- FOUND REBAR & CAP STAMPED "CEI RP"
- AA##A# ALAMEDA COUNTY MONUMENT ID
- 19592 REFERENCE STREET ADDRESS

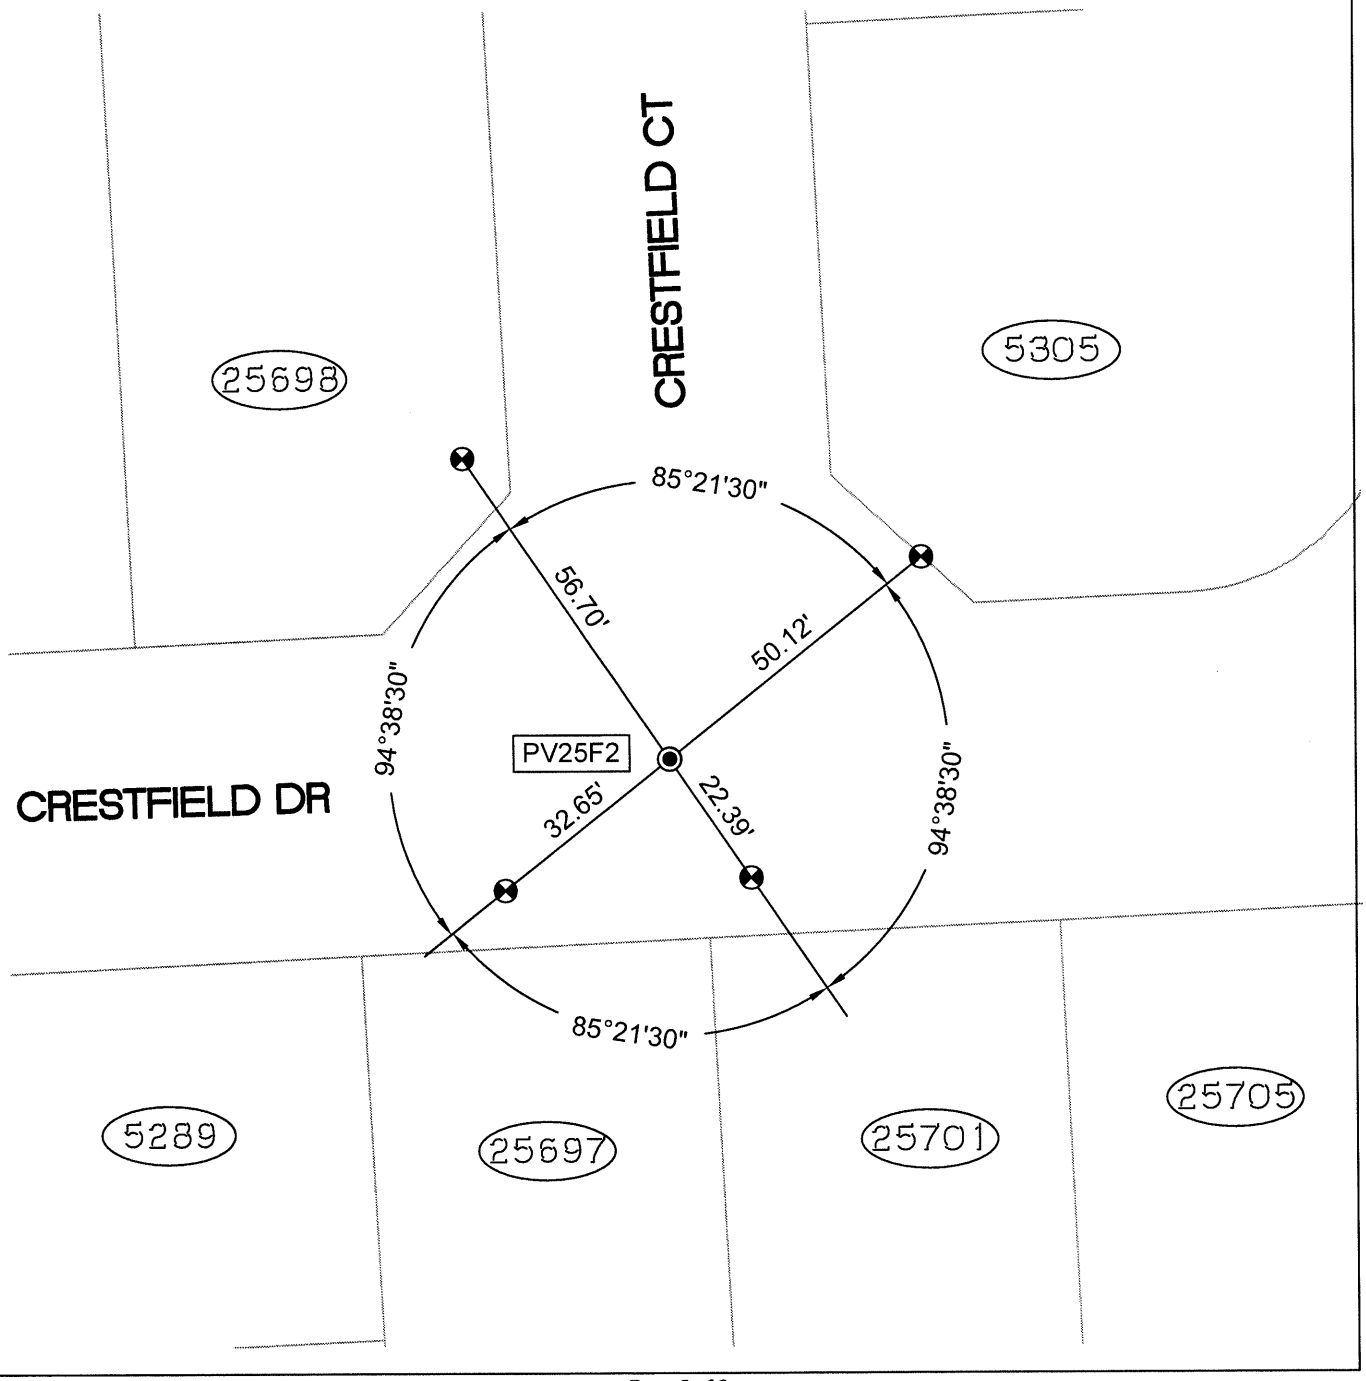

216178-CRESTFIELD-CR05 post